LEGEND

- HORIZONTAL MOUNTED AXIAL TYPE FAN
- IN-LINE CENTRIFUGAL FAN / CENTRIFUGAL FAN
- VOLUME CONTROL DAMPER
- MOTORIZED ON/OFF FIRE & SMOKE DAMPER TO UL555S
- WEATHERPROOF LOUVRE (50% EFFECTIVE AREA)
- HORIZONTAL AIR GRILLE
- VERTICAL AIR GRILLE
- FIRE RATED ENCLOSURE (FRR 240/240/240) COMPLY WITH BS476:PART 24
- MAKE-UP / FRESH DUCT F/B OR T/B
- MAKE-UP AIR FRESH DUCT F/A OR T/A
- SMOKE EXTRACTION / EXHAUST AIR DUCT F/B OR T/B
- SMOKE EXTRACTION / EXHAUST AIR DUCT F/A OR T/A
- SMOKE DETECTOR (BUILDING AFA)
- SMOKE DETECTOR (AAD)
- SCP SUPERVISORY CONTROL PANEL
- LOCAL MOTOR CONTROL PANEL
- AIR FLOW DIRECTION
- EXIT SIGN
- AIR FLOW SWITCH
- LOCAL MOTOR CONTROL PANEL (LMCP) (C/W FIRE RATED ENCLOSURE (FRR 120/120/120) W/ SELF-CLOSING DOOR)
- SILENCER
- F SPRINKLER FLOW SWITCH
- F FLOOR MOUNTED WARNING SIGN (REFER TO DETAIL 1 OF 3/F LAYOUT– DWG NO. 2503373A/SES/201)
- F SES AV SIGNAL FOR SES (REFER TO DETAIL 2 OF 3/F LAYOUT– DWG NO. 2503373A/SES/201)
- YELLOR & BLACK STRIPE CAUTION ADHESIVE FLOOR TAPE B

ABBREVIATIONS:

AFFL	ABOVE FINISHED FLOOR LEVEL
AFA	AUTOMATIC FIRE ALARM
AP	ACCESS PANEL
C/W	COMPLETED WITH
DN	DOWN
EAD	EXHAUST AIR DUCT
EAF	EXHAUST AIR FAN
EAG	EXHAUST AIR GRILLE
EAL	EXHAUST AIR LOUVRE
FAD	FRESH AIR DUCT
FAF	FRESH AIR FAN
FAG	FRESH AIR GRILLE
FAL	FRESH AIR INTAKE LOUVRE
FS	FIRE SERVICES
F/A	FROM ABOVE
F/B	FROM BELOW
FD	FIRE DAMPER
FR	FIRE RATED
FRP	FIRE RATED PERIOD
FRR	FIRE RESISTANCE RATING
H/L	HIGH LEVEL
L/L	LOW LEVEL
LMCP	LOCAL MOTOR CONTORL PANEL
MAD	MAKE-UP AIR DUCT
MAF	MAKE-UP AIR FAN
MAG	MAKE-UP AIR GRILLE
MAL	MAKE-UP AIR LOUVRE
MFSD	MOTORIZED FIRE AND SMOKE DAMPER
M/L	MID LEVEL
MOD	MODULATING DAMPER
N/C	NORMALLY CLOSE
N/O	NORMALLY OPEN
SCP	SUPERVISORY CONTROL PANEL
SE	SMOKE EXTRACTION
SED	SMOKE EXTRACTION DUCT
SEF	SMOKE EXTRACTION FAN
SEG	SMOKE EXTRACTION GRILLE
SEL	SMOKE EXTRACTION LOUVRE
SES	SMOKE EXTRACTION SYSTEM
T/A	TO ABOVE
T/B	TO BELOW
TYP	TYPICAL
VCD	VOLUME CONTROL DAMPER
V.D.	VENT DUCT
WP	WEATHERPROOF

DIFFUSER / GRILLE SIZE LEGEND

A
B
C
D

OR

A
B
C
D
E
F

A = NUMBER
B = TYPE
- WP – WEATHERPROOF
- SEG – SMOKE EXTRACTION GRILLE
- MAG – MAKE-UP AIR GRILLE
- SEL – SMOKE EXTRACTION LOUVRE
- MAL – MAKE-UP AIR LOUVRE
- *WEATHER PROOF LOUVRE EFFICIENCY IS ASSUMED TO BE 50%
- *AIR GRILLE EFFICIENCY IS ASSUMED TO BE 70%

C = DIMENSION (mm)
D = FLOW RATE (L/s)
E = FREE AREA VELOCITY (m/s)
F = BOTTOM LEVEL ABOVE FINISHED FLOOR LEVEL (mm)

BS 4800 COLOUR

- FAD (FRESH AIR DUCT) (FOR GENERAL VENTILATION)
- EAD (EXHAUST AIR DUCT)) (FOR GENERAL VENTILATION)
- SED (SMOKE EXTRACTION DUCT) (FOR DYNAMIC SMOKE EXTRACTION)
- MAD (MAKE UP AIR DUCT) (FOR DYNAMIC SMOKE EXTRACTION)

Patrick 18.8.26

EQUIPMENT NOTATION

A
B C
(D)

A = EQUIPMENT ABBREVIATION
- SEF – SMOKE EXTRACTION FAN
- MAF – MAKEUP AIR FAN

B = LEVEL (FLOOR)
C = UNIT NUMBER
D = FLOW RATE (L/s)

A-B-C-D

A = DAMPER ABBREVIATION
- MFSD – MOTORIZED FIRE AND SMOKE DAMPER
- MMD – MOTORIZED MODULATING DAMPER


B = DAMPER INSTALLATION LOCATION
- SEF – SMOKE EXTRACTION FAN
- SEG – SMOKE EXTRACTION GRILLE
- MAF – MAKEUP AIR FAN
- MAG – MAKEUP AIR GRILLE

C = LEVEL (FLOOR)
D = UNIT NUMBER

DRAWING LISTS

DRAWING NO.	REV.	SCALE	DRAWING TITLE
2503373A/SES/001	B	NTS@A0	SMOKE EXTRACTION SYSTEM–LEGENDS, ABBREVIATIONS, BLOCK PLAN & DRAWING LIST
2503373A/SES/002	B	NTS@A0	SMOKE EXTRACTION SYSTEM–GENERAL NOTES AND AIR FLOW SUMMARY
2503373A/SES/003	B	NTS@A0	SMOKE EXTRACTION SYSTEM–CALCULATION SUMMARY & ZONING PLAN
2503373A/SES/101	B	NTS@A0	SMOKE EXTRACTION SYSTEM–SCHEMATIC DRAWING
2503373A/SES/102	A	NTS@A0	SMOKE EXTRACTION SYSTEM–MODE TABLE
2503373A/SES/103	A	NTS@A0	SMOKE EXTRACTION SYSTEM–SUPERVISORY CONTROL PANEL DIAGRAM
2503373A/SES/104	A	NTS@A0	SMOKE EXTRACTION SYSTEM–LOCAL MOTOR CONTROL PANEL DIAGRAM (SHEET 1 OF 3)
2503373A/SES/105	A	NTS@A0	SMOKE EXTRACTION SYSTEM–LOCAL MOTOR CONTROL PANEL DIAGRAM (SHEET 2 OF 3)
2503373A/SES/106	A	NTS@A0	SMOKE EXTRACTION SYSTEM–LOCAL MOTOR CONTROL PANEL DIAGRAM (SHEET 3 OF 3)
2503373A/SES/201	B	1:100@A0	SMOKE EXTRACTION SYSTEM–3F LAYOUT
2503373A/SES/202	B	1:100@A0	SMOKE EXTRACTION SYSTEM–2F LAYOUT
2503373A/SES/203	B	1:100@A0	SMOKE EXTRACTION SYSTEM–1F LAYOUT
2503373A/SES/204	B	1:100@A0	SMOKE EXTRACTION SYSTEM–GF LAYOUT (1 OF 2)
2503373A/SES/205	B	1:100@A0	SMOKE EXTRACTION SYSTEM–GF LAYOUT (2 OF 2)
2503373A/SES/206	B	1:100@A0	SMOKE EXTRACTION SYSTEM–B1F LAYOUT (1 OF 2)
2503373A/SES/207	B	1:100@A0	SMOKE EXTRACTION SYSTEM–B1F LAYOUT (2 OF 2)
2503373A/SES/208	B	1:100@A0	SMOKE EXTRACTION SYSTEM–B2F LAYOUT
2503373A/SES/301	B	1:100@A0	SMOKE EXTRACTION SYSTEM–SOUTH ELEVATION
2503373A/SES/302	B	1:100@A0	SMOKE EXTRACTION SYSTEM–WEST ELEVATION
2503373A/SES/303	B	1:100@A0	SMOKE EXTRACTION SYSTEM–EAST NORTH ELEVATION
D-EE-101	B	NTS@A0	SMOKE EXTRACTION SYSTEM – ELECTRICAL & LMCP WIRING DIAGRAM (1 OF 2)
D-EE-102	B	NTS@A0	SMOKE EXTRACTION SYSTEM – ELECTRICAL & LMCP WIRING DIAGRAM (2 OF 2)
~~FS-103~~	~~A~~	~~NTS@A0~~	~~SPRINKLER SYSTEM SCHEMATIC DIAGRAM (SHEET 1 OF 2)~~
~~FS-105~~	~~A~~	~~NTS@A0~~	~~AFA SYSTEM SCHEMATIC DIAGRAM (SHEET 1 OF 2)~~
FS-201	B	1:150@A0	FIRE SERIVCE LAYOUT OF B2/F
FS-202	B	1:150@A0	FIRE SERIVCE LAYOUT OF B1/F

Patrick
18.8.26
LOO Kwan Wai
(RPE NO.: RP0260258)

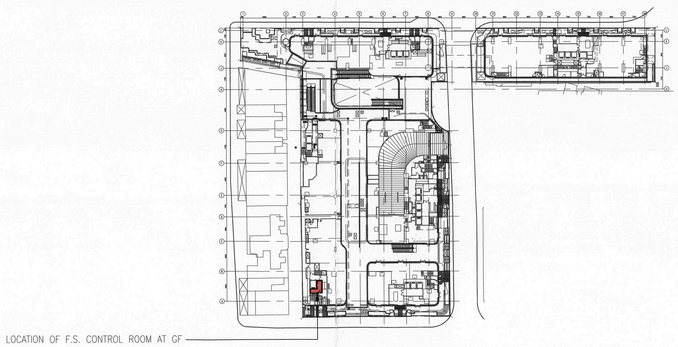

BLOCK PLAN AT GROUND FLOOR(G/F) SCALE 1:2000



F.S. CONTROL ROOM ON G/F
SCALE 1:100

NO.	DATE	REVISIONS	DRAFTED	CHECKED	DESIGNED	REVIEWED
B	06/2026	FSD THIRD SUBMISSION	HYH	WWC	HYH	TKL
A	09/2025	FSD SECOND SUBMISSION	HYH	WWC	HYH	TKL
0	05/2025	FSD FIRST SUBMISSION	HYH	WWC	HYH	TKL

CLIENT:

NATION STAR DEVELOPMENT LIMITED
75/F, 8 Finance Street,
Central, Hong Kong

PROJECT ARCHITECT & AUTHORIZED PERSON:

RONALD LU & PARTNERS
呂元祥建築師事務所
33rd Floor, Wu Chung house, 213 Queen's Road East,
Wanchai, Hong Kong

STRUCTURAL/GEOTECHNICAL:

wsp
7/F, One Kowloon
1 Wang Yuen Street
Kowloon Bay, Hong Kong

BUILDING SERVICES ENGINEER:

wsp
7/F, One Kowloon
1 Wang Yuen Street
Kowloon Bay, Hong Kong

QUANTITY SURVEYOR:

ARCADIS
17/F, Two Harbour Square, 180 Wai Yip Street,
Kwun Tong, Kowloon
Hong Kong

FIRE SERVICES CONTRACTOR:

開創工程有限公司
GRAND CREATIVE ENGINEERS LIMITED

PROJECT:

PROPOSED DEVELOPMENT AT BAILEY STREET & WING KWONG STREET, TO KWA WAN, KOWLOON
INLAND LOT NO. 11279
(URA PROJECT KC-009)

TITLE:

SMOKE EXTRACTION SYSTEM – LEGENDS, ABBREVIATIONS, DRAWING LIST, BLOCK PLAN

DATE: 06/2026		SCALE: NTS@A0	
DRAFTED: HYH	CHECKED: WWC	DESIGNED: HYH	REVIEWED: TKL
JOB NO. 2503373A	DRAWING NO. 2503373A/SES/001		REV. NO. B